

Jairo GomezFacio

From: Travis Starley <tstarley@usmechanicalllc.com>
Sent: Thursday, May 21, 2026 1:49 PM
To: Avery Hacker; Justun Bylund
Cc: Derek Rosse; Michael Ruesch; Jon Cox; Jairo GomezFacio; Keith LaRue
Subject: RE: US Mech Scope Review Meeting Minutes - Tonopah Field Replacement

Avery,

Here are the costs for the items discussed during the descope.

- 1- Insulate Condensate- \$4,148
- 2- Seal Wall Penetrations- \$2,085
- 3- Hard dig and spoils haul off is included
- 4- Sawcut, cap below, pour back- \$31,013
- 5- Alternate 1 site finishes- TBD
- 6- BMS- TBD
- 7- Requested low ambient kit- NW has included snow/wind hoods for the unit

I have requested pricing from Mtn West for the put back of site finishes and will get that cost back to you asap.

I have also attached the routing of the propane line we have included. We really need more information for both the routing and the new tank to price this up accurately.

Thanks,

Travis Starley
472 S 640 W
Pleasant Grove UT 84062
801-796-2075 office
702-544-2303 cell
801-785-6023 fax
tstarley@usmechanicalllc.com
www.usmechanicalllc.com



From: Avery Hacker <averyhacker@coreconstruction.com>
Sent: Monday, May 18, 2026 12:21 PM
To: Justun Bylund <jbylund@usmechanicalllc.com>; Travis Starley <tstarley@usmechanicalllc.com>
Cc: Derek Rosse <derekrosse@coreconstruction.com>; Michael Ruesch <michaelruesch@coreconstruction.com>; Jon Cox <joncox@coreconstruction.com>; Jairo GomezFacio <jairogomezfacio@coreconstruction.com>; Keith LaRue

<keithlarue@coreconstruction.com>

Subject: US Mech Scope Review Meeting Minutes - Tonopah Field Replacement

Justun and Travis,

Thanks again for meeting with us this morning. See the attached notes from the meeting with HW items highlighted in yellow. As discussed, please get back to us with responses to the HW by end of day Thursday.

Thank you,


Avery Hacker

Project Director

CORE Construction | West

P: 702-794-0550 | C: 702-467-3830 | W: coreconstruction.com

E: averyhacker@coreconstruction.com

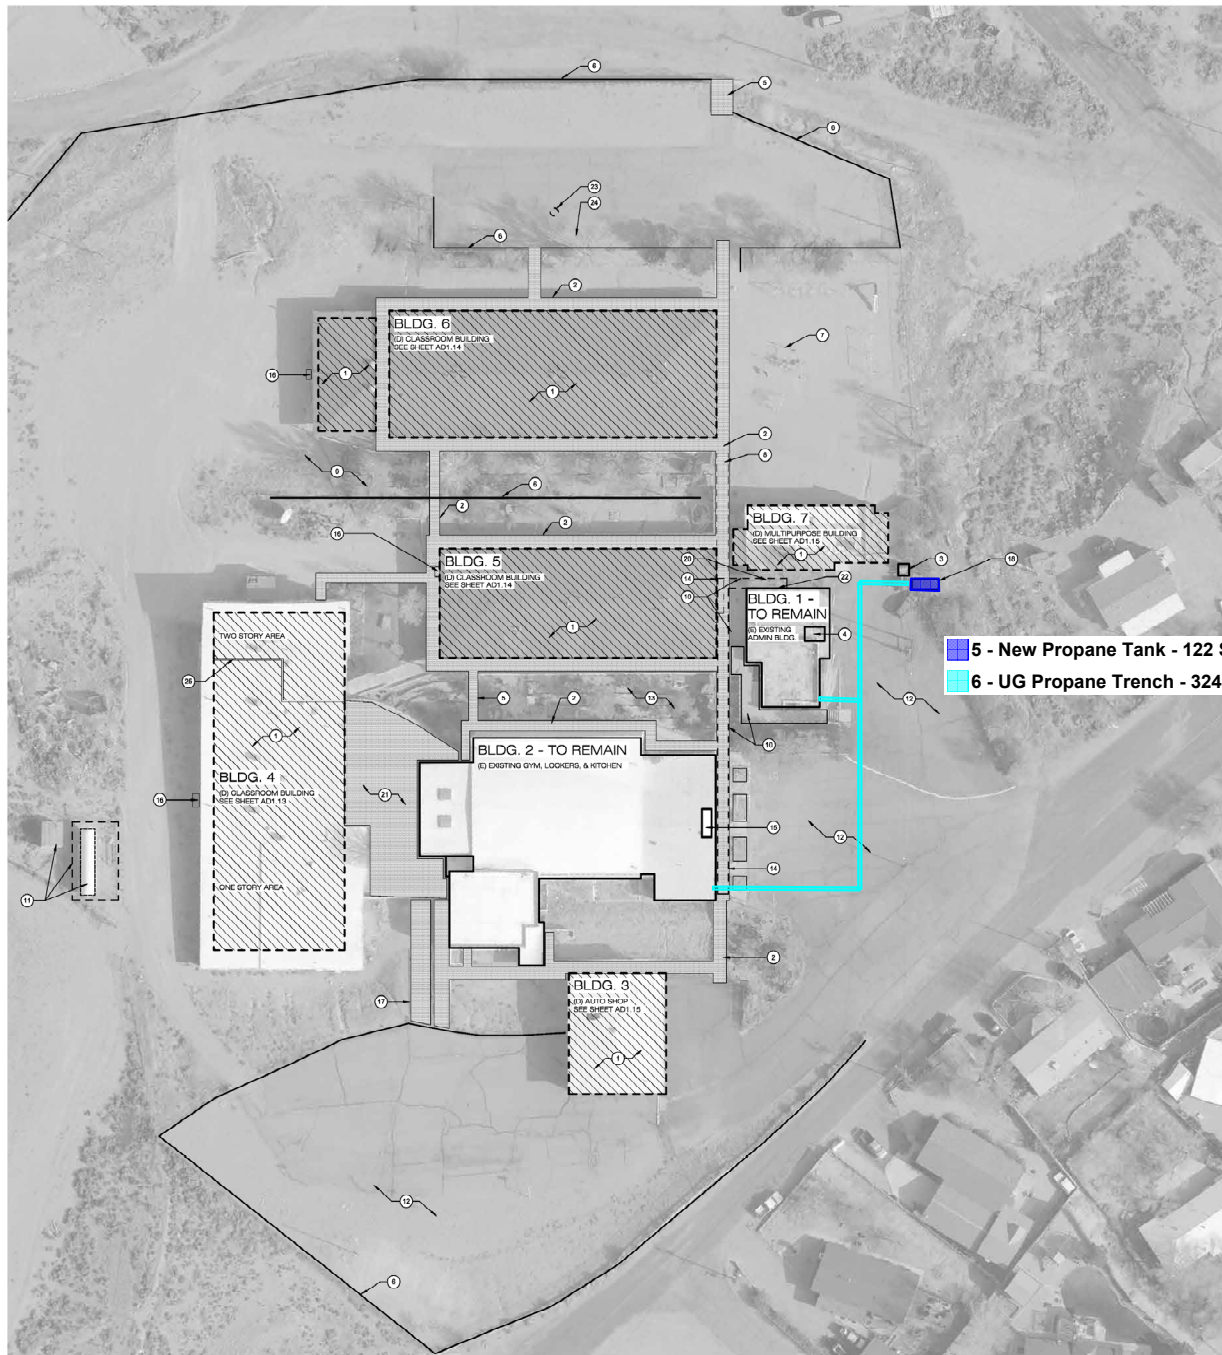

DEMOLITION NOTES

1. THE GENERAL CONTRACTOR SHALL COORDINATE ACCESS WITH NCSU FOR THEIR 2 WEEK SCHEDULED ON-SITE VISIT.
2. THE GENERAL CONTRACTOR SHALL VERIFY AND CONFIRM THAT ALL UTILITIES ON-SITE ARE PROPERLY LOCATED AND/OR DISCONNECTED AND SECURELY CAPPED BEFORE DEMOLITION BEGINS.
3. FIELD VERIFY EXISTING CONDITIONS PRIOR TO THE START OF DEMOLITION OPERATIONS. BRING ANY DISCREPANCIES WHICH MAY SIGNIFICANTLY AFFECT DEMOLITION OR NEW CONSTRUCTION WORK TO THE ATTENTION OF THE ARCHITECT FOR REVIEW.
4. PROTECT EXISTING STRUCTURES TO REMAIN FROM DAMAGE DURING DEMOLITION. CONDUCT DEMOLITION TO MINIMIZE THE DEVELOPMENT AND SPREAD OF DUST.
5. REMOVE DEMOLITION MATERIALS FROM SITE PROMPTLY AND DISPOSE OF LEGALLY OFF-SITE.
6. PROVIDE DEMOLITION WORK SHOWN ON THE DRAWINGS AND RELATED INCIDENTAL DEMOLITION WORK REQUIRED TO COMPLETE NEW CONSTRUCTION WORK. REFER TO CIVIL, PLUMBING, MECHANICAL, AND ELECTRICAL FOR ADDITIONAL DEMOLITION SCOPE AND REQUIREMENTS.
7. MAINTAIN MEANS OF EGRESS AND KEEP FULLY SEPARATE FROM CONSTRUCTION AREA AT ALL TIMES.
8. CONDUCT DEMOLITION ACTIVITIES TO PREVENT INJURY TO PEOPLE AND DAMAGE TO ADJACENT BUILDING AREAS. ENSURE SAFE PASSAGE OF PEOPLE AND PROTECT SELECTIVE DEMOLITION AREAS. IT IS ANTICIPATED THAT BUILDINGS 1 AND BUILDING 2 WILL BE OCCUPIED DURING DEMOLITION. COORDINATE WITH OWNER.
9. CLEAN ADJACENT STRUCTURES AND IMPROVEMENTS OF DIRT, GRIT AND DEBRIS CAUSED BY SELECTIVE DEMOLITION AND NEW CONSTRUCTION OPERATIONS.
10. COMPLETED SITE DEMOLITION WITHIN THE LIMITS OF WORK SHALL BE IN A CONDITION THAT PREPARES THE SITE FOR NEW CONSTRUCTION THAT INCLUDES BUT IS NOT LIMITED TO GRADING, NEW UNDERGROUND UTILITY INSTALLATION AND ABOVE GROUND NEW CONSTRUCTION.
11. IF THE PRESENCE OF ASBESTOS IS DETERMINED PRIOR TO DEMOLITION, THE CONTRACTOR SHALL REVIEW THE SURVEY AND RETAIN A LEAD AND ASBESTOS ABATEMENT CONTRACTOR TO REMOVE ALL CONTAMINANTS PRIOR TO DEMOLITION IN ACCORDANCE WITH APPROPRIATE REGULATIONS. A LEAD AND ASBESTOS ABATEMENT CONTRACTOR SHALL COORDINATE THE WORK, PROVIDE SCHEDULES AND ADMINISTER PAPERWORK WITH GENERAL CONTRACTOR FOR THE SURVEY AND INSPECTION REPORT. CONTRACTOR SHALL REPORT TO THE OWNER FOR INSTRUCTIONS IF THERE IS ANY HOLD-UP DURING INVESTIGATION PRIOR TO DEMOLITION.

LANDSCAPE DEMOLITION NOTES

1. REEL ALL TREES ON-SITE (45) AND GRIND STUMP FLUSH WITH GRADE.
2. REMOVE ALL SH-RUBS COMPLETELY.
3. TURN OFF ALL IRRIGATION AT SPRINKLERS AND/OR MAIN WATER LINE.

DEMOLITION KEYNOTES

1. EXISTING BUILDING (TO BE DEMOLISHED). EXISTING SLAB (TO REMAIN IN PLACE).
2. EXISTING SIDEWALK, STAIRS AND RAMP (TO REMAIN).
3. EXISTING TRANSFORMER TO REMAIN. GO TO DISCONNECT AND REMOVE FEEDERS FROM BUILDINGS TO BE DEMOLISHED.
4. LOCATION OF EXISTING ELECTRICAL ROOMS (AND SWITCHGEAR) TO REMAIN.
5. EXISTING STAIR AND ASSOCIATED RAILING TO REMAIN.
6. EXISTING RETAINING WALL/FENCE TO REMAIN.
7. EXISTING PLAYGROUND EQUIPMENT TO BE REMOVED AND DISPOSED OF (TYP. OF EQUIPMENT: 5 PIECES).
8. EXISTING METAL CANOPY TO BE REMOVED. SALVAGE 10 STEEL POST TO BE REUSED. SHOWN DASHED.
9. EXISTING FLATWORK INCLUDING SIDEWALKS, ASPHALT PAVING AND LANDSCAPING TO REMAIN.
10. EXISTING METAL CANOPY OVER STAIRS/SIDEWALK TO REMAIN (SHOWN DASHED).
11. EXISTING FIREWATER TANK, ENCLOSURE AND FENCE LINE TO BE REMOVED.
12. EXISTING RAISED LANDSCAPE AREA TO REMAIN.
13. EXISTING METAL CANOPY OVER ENTRY TO REMAIN.
14. APPROXIMATE LOCATION OF EXISTING 8" DIA. 8" DEEP FOR CUMULATIVE (TYP.).
15. EXISTING PAVED HAMPIR TO REMAIN.
16. APPROXIMATE LOCATION OF NEW FIREWATER TANK TO SERVICE EXISTING BUILDINGS. COORDINATE WITH OWNER.
17. NOT USED.
18. CUT AND CAP EXISTING ABOVE ROOF PROPANE LINE.
19. EXISTING OUTDOOR PAVILION W/ CONCRETE, PLANTERS AND TREES TO REMAIN. POOL FOR NEW PROPANE SERVICE.
20. APPROXIMATE LOCATION OF EXISTING WATER TO REMAIN.
21. APPROXIMATE LOCATION OF EXISTING WATER TO REMAIN.
22. APPROXIMATE LOCATION OF EXISTING WATER TO REMAIN.
23. APPROXIMATE LOCATION OF EXISTING WATER TO REMAIN.
24. EXISTING EXTERIOR RETAINING WALL TO REMAIN.
25. EXISTING INTERIOR RETAINING WALL TO REMAIN.

ISSUE DATE 04.20.2026

REV DATE COMMENT



DEMOLITION PLAN - ES

TONOPAH ELEMENTARY SCHOOL

1385 W. Idaho Creek, Tonopah, NV 89069

NYE COUNTY SCHOOL DISTRICT

TITLE PROJECT CLIENT

JOB NO: 210090

AD1.11



DEMO SITE PLAN ES

1" = 30'-0"